

General Notes


1. Elevation mark 0.000 corresponds to the finished floor level
2. Walls: pre-finishing stage; screed leveled with the finished floor
3. Corners: all corners are 90°, unless otherwise indicated on the plan. As-built plan tolerance: ±50 mm. Corner deviation: ±5°
4. Room heights: indicated from the finished floor level

Symbols and Abbreviations

- Sewer pipe
- HWS / CWS
- Ventilation shaft
- Kitchen area
- Wet area
- Ventilation outlet
- Room designation
- H_{np} Opening height
- Γ_{np} Opening depth
- $H_{ок}$ Window height
- $\text{Ш}_{ок}$ Window width
- $H_{под}$ Window sill height
- $H_{порог}$ Threshold height
- H Floor-to-ceiling height
- $H_{дв}$ Door height

Room schedule, 1st floor
(as-built plan)

01	Kitchen	16.02 m ²
02	Storage room	1.10 m ²
03	Entrance hall	5.59 m ²
04	Corridor 1	5.51 m ²
05	Corridor 2	4.47 m ²
06	Bathroom 1	4.08 m ²
07	Master bedroom	19.15 m ²
08	Balcony 1	4.37 m ²
09	Living room	31.13 m ²
10	Balcony 2	9.30 m ²
11	Corridor 3	2.35 m ²
12	Bedroom 1	19.29 m ²
13	Balcony 3	4.58 m ²
14	Bathroom 2	5.34 m ²
15	Bedroom 2	17.24 m ²
In total: 15		149.52 m ²

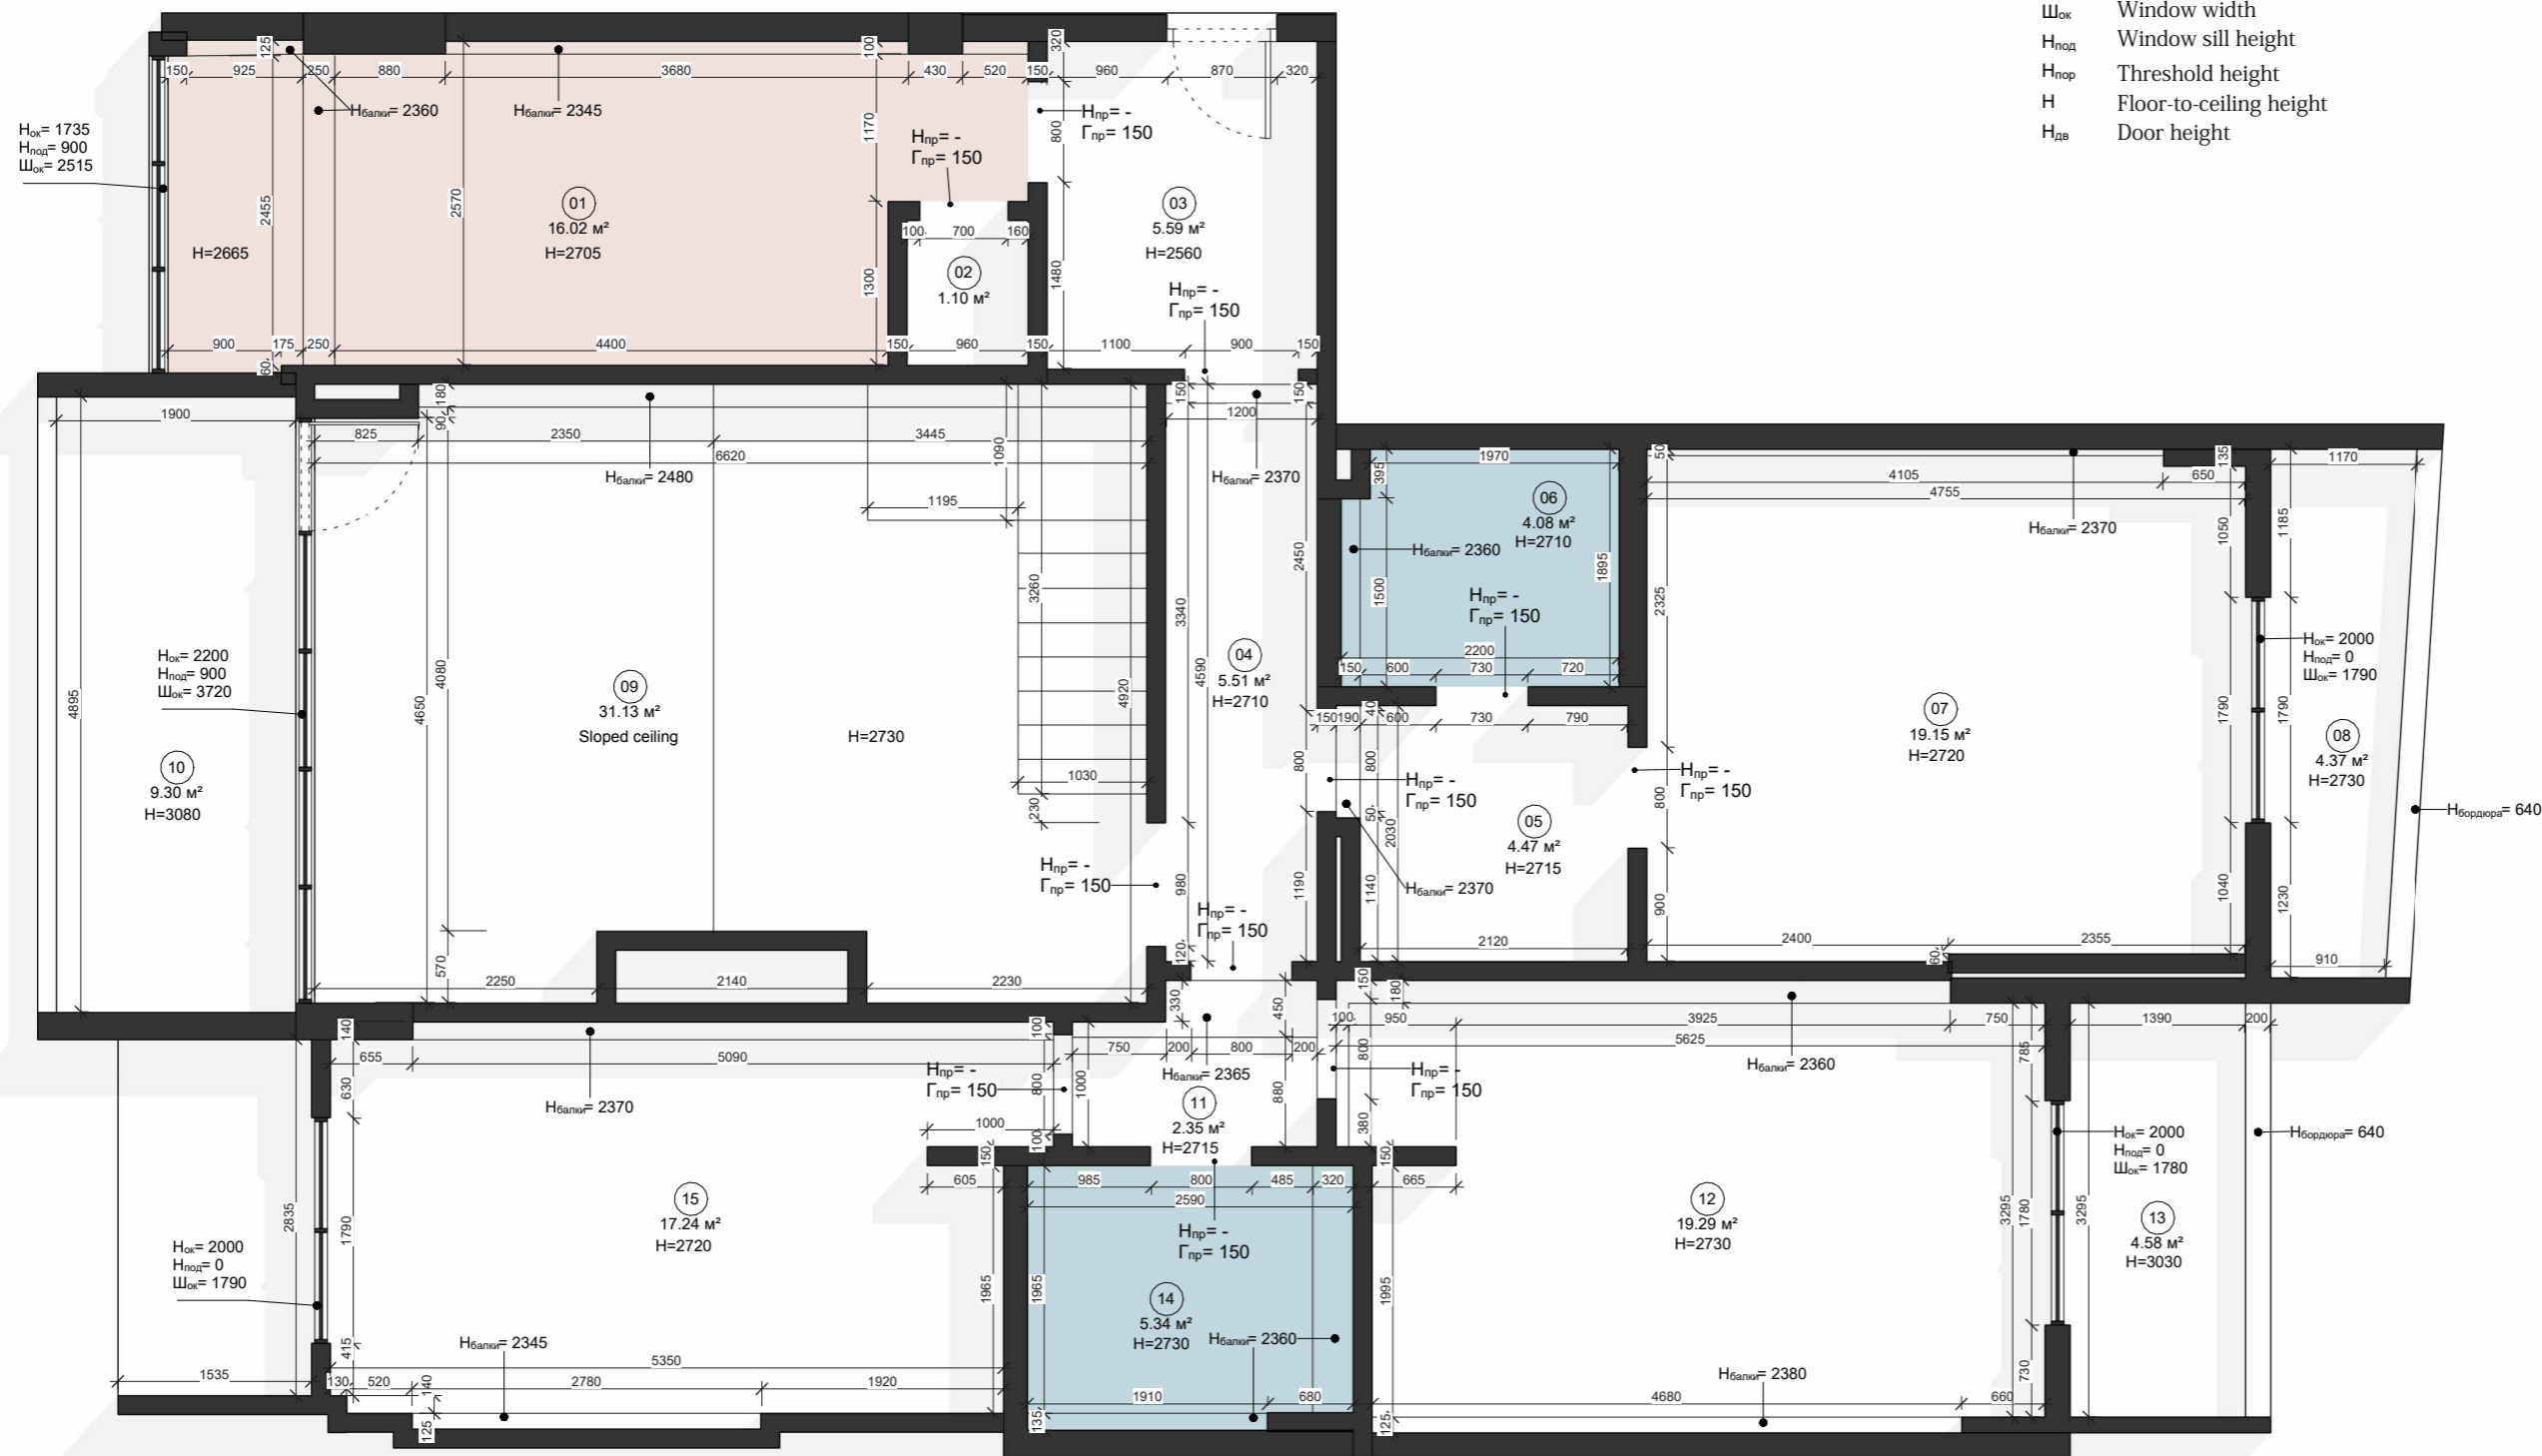

Scale


1:100

General Notes

1. Elevation mark 0.000 corresponds to the finished floor level
2. Walls: pre-finishing stage; screed leveled with the finished floor
3. Corners: all corners are 90°, unless otherwise indicated on the plan. As-built plan tolerance: ±50 mm. Corner deviation: ±5°
4. Room heights: indicated from the finished floor level

Symbols and Abbreviations

- Sewer pipe
- HWS / CWS
- Ventilation shaft
- Kitchen area
- Wet area
- Ventilation outlet
- Room designation
- H_{np} Opening height
- Γ_{np} Opening depth
- $H_{ок}$ Window height
- $\text{Ш}_{ок}$ Window width
- $H_{под}$ Window sill height
- H_{nop} Threshold height
- H Floor-to-ceiling height
- $H_{дв}$ Door height

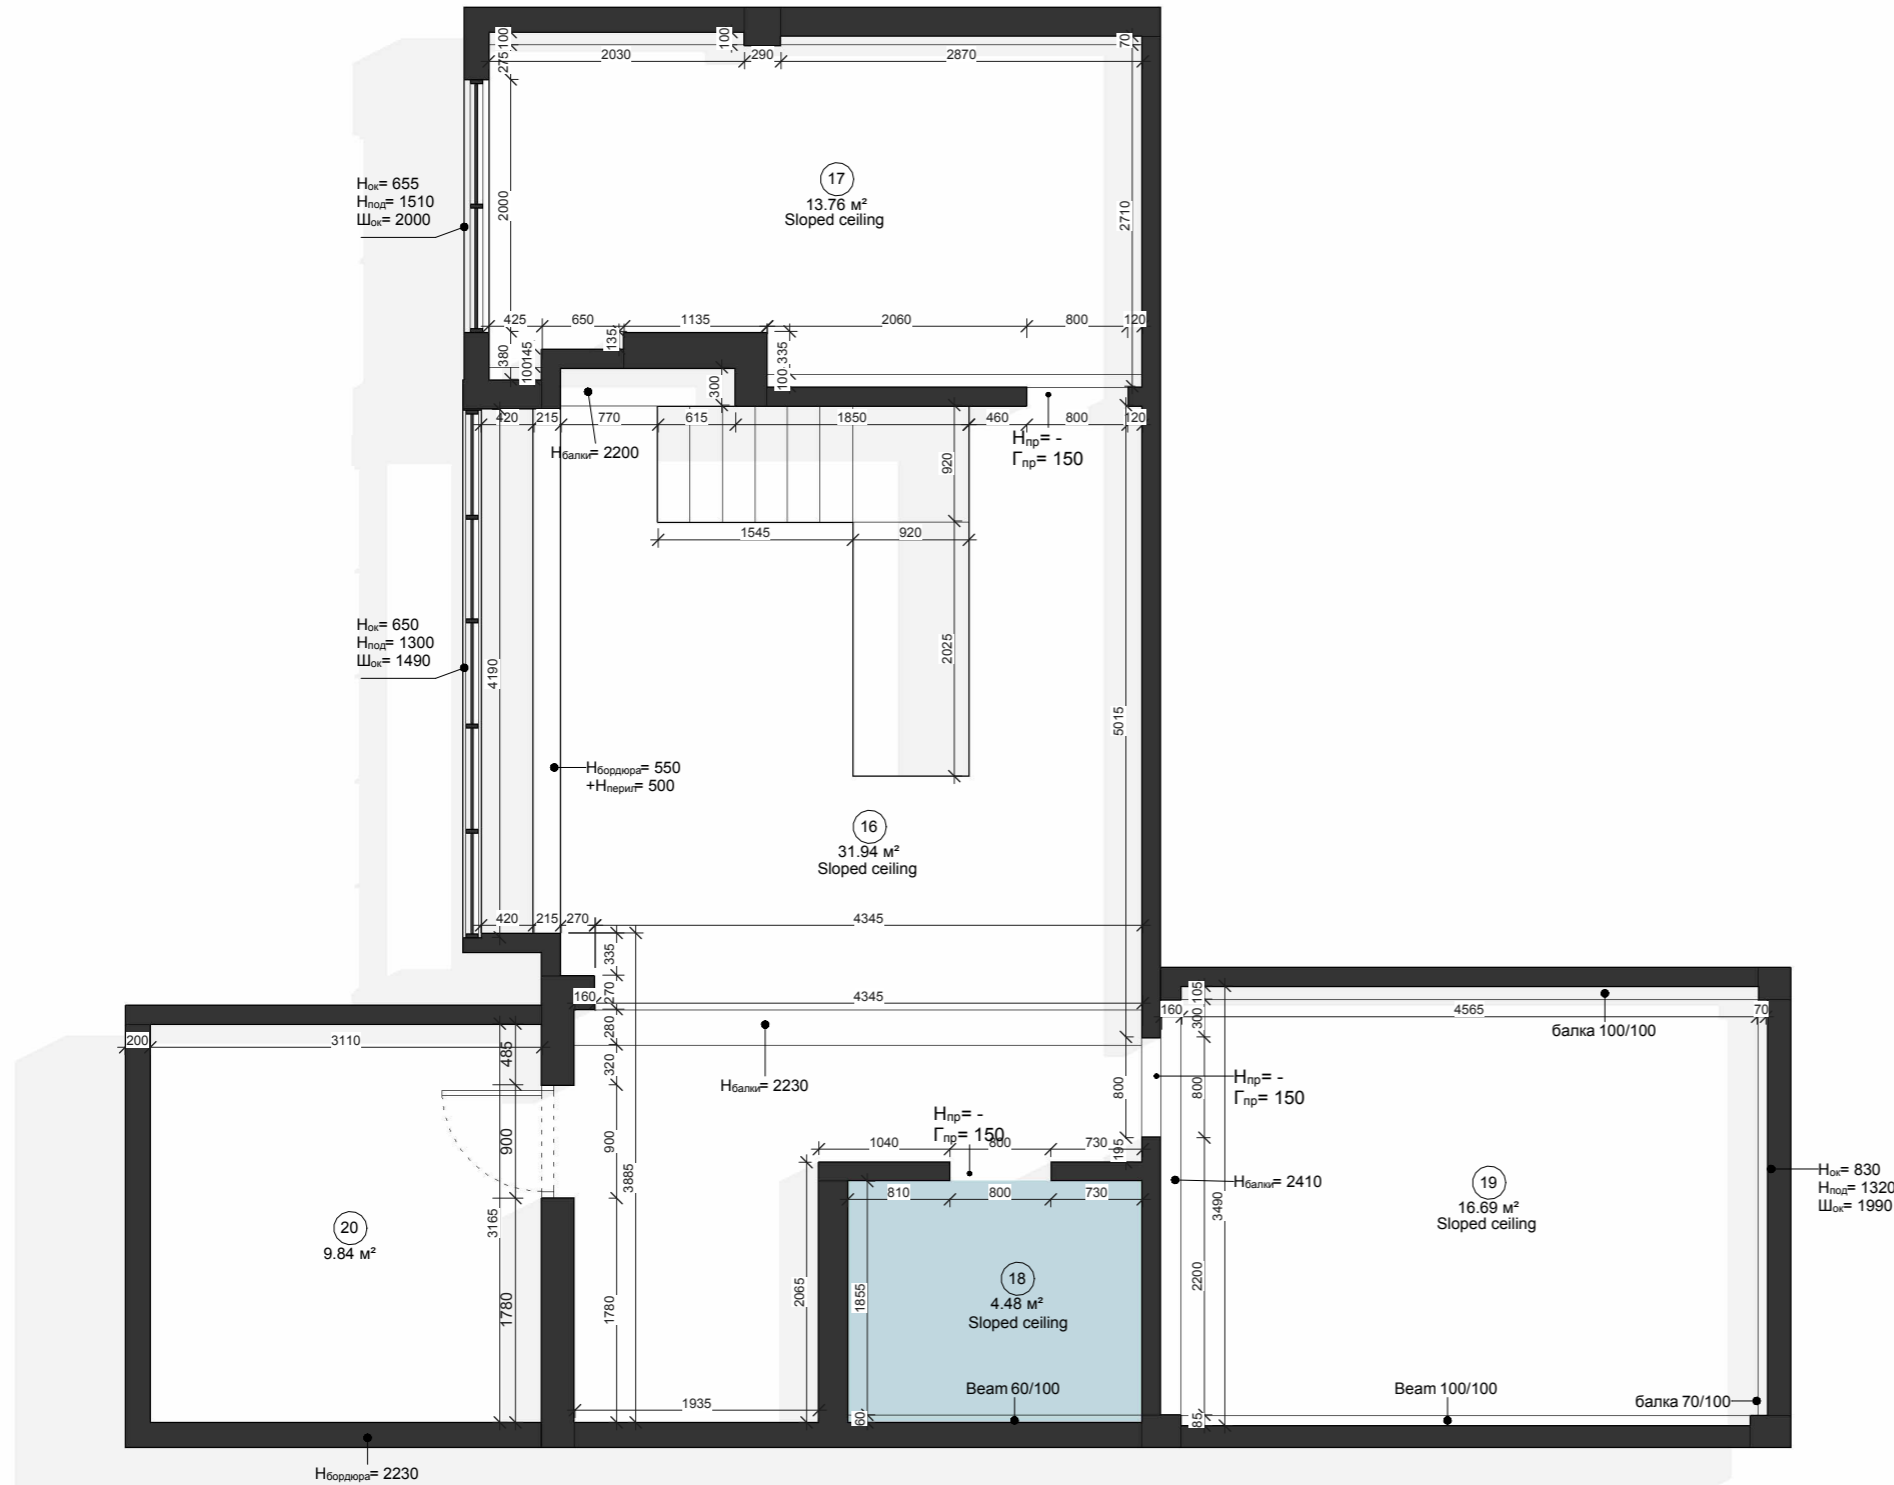



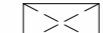

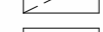
Room schedule, 2nd floor
(as-built plan)


16	Living room	31.94 m ²
17	Bedroom 3	13.76 m ²
18	Bathroom 3	4.48 m ²
19	Bedroom 4	16.69 m ²
20	Balcony 5	9.84 m ²
In total: 5		76.71 m ²

General Notes

1. Elevation mark 0.000 corresponds to the finished floor level (F.F.L.)
2. Final room dimensions may be adjusted after wall installation and plastering

Legend

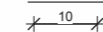-  Main dimensions
-  Critical dimensions (must be observed)
-  Full-height wardrobe (to ceiling)
-  Wall-mounted cabinet
-  Cabinet

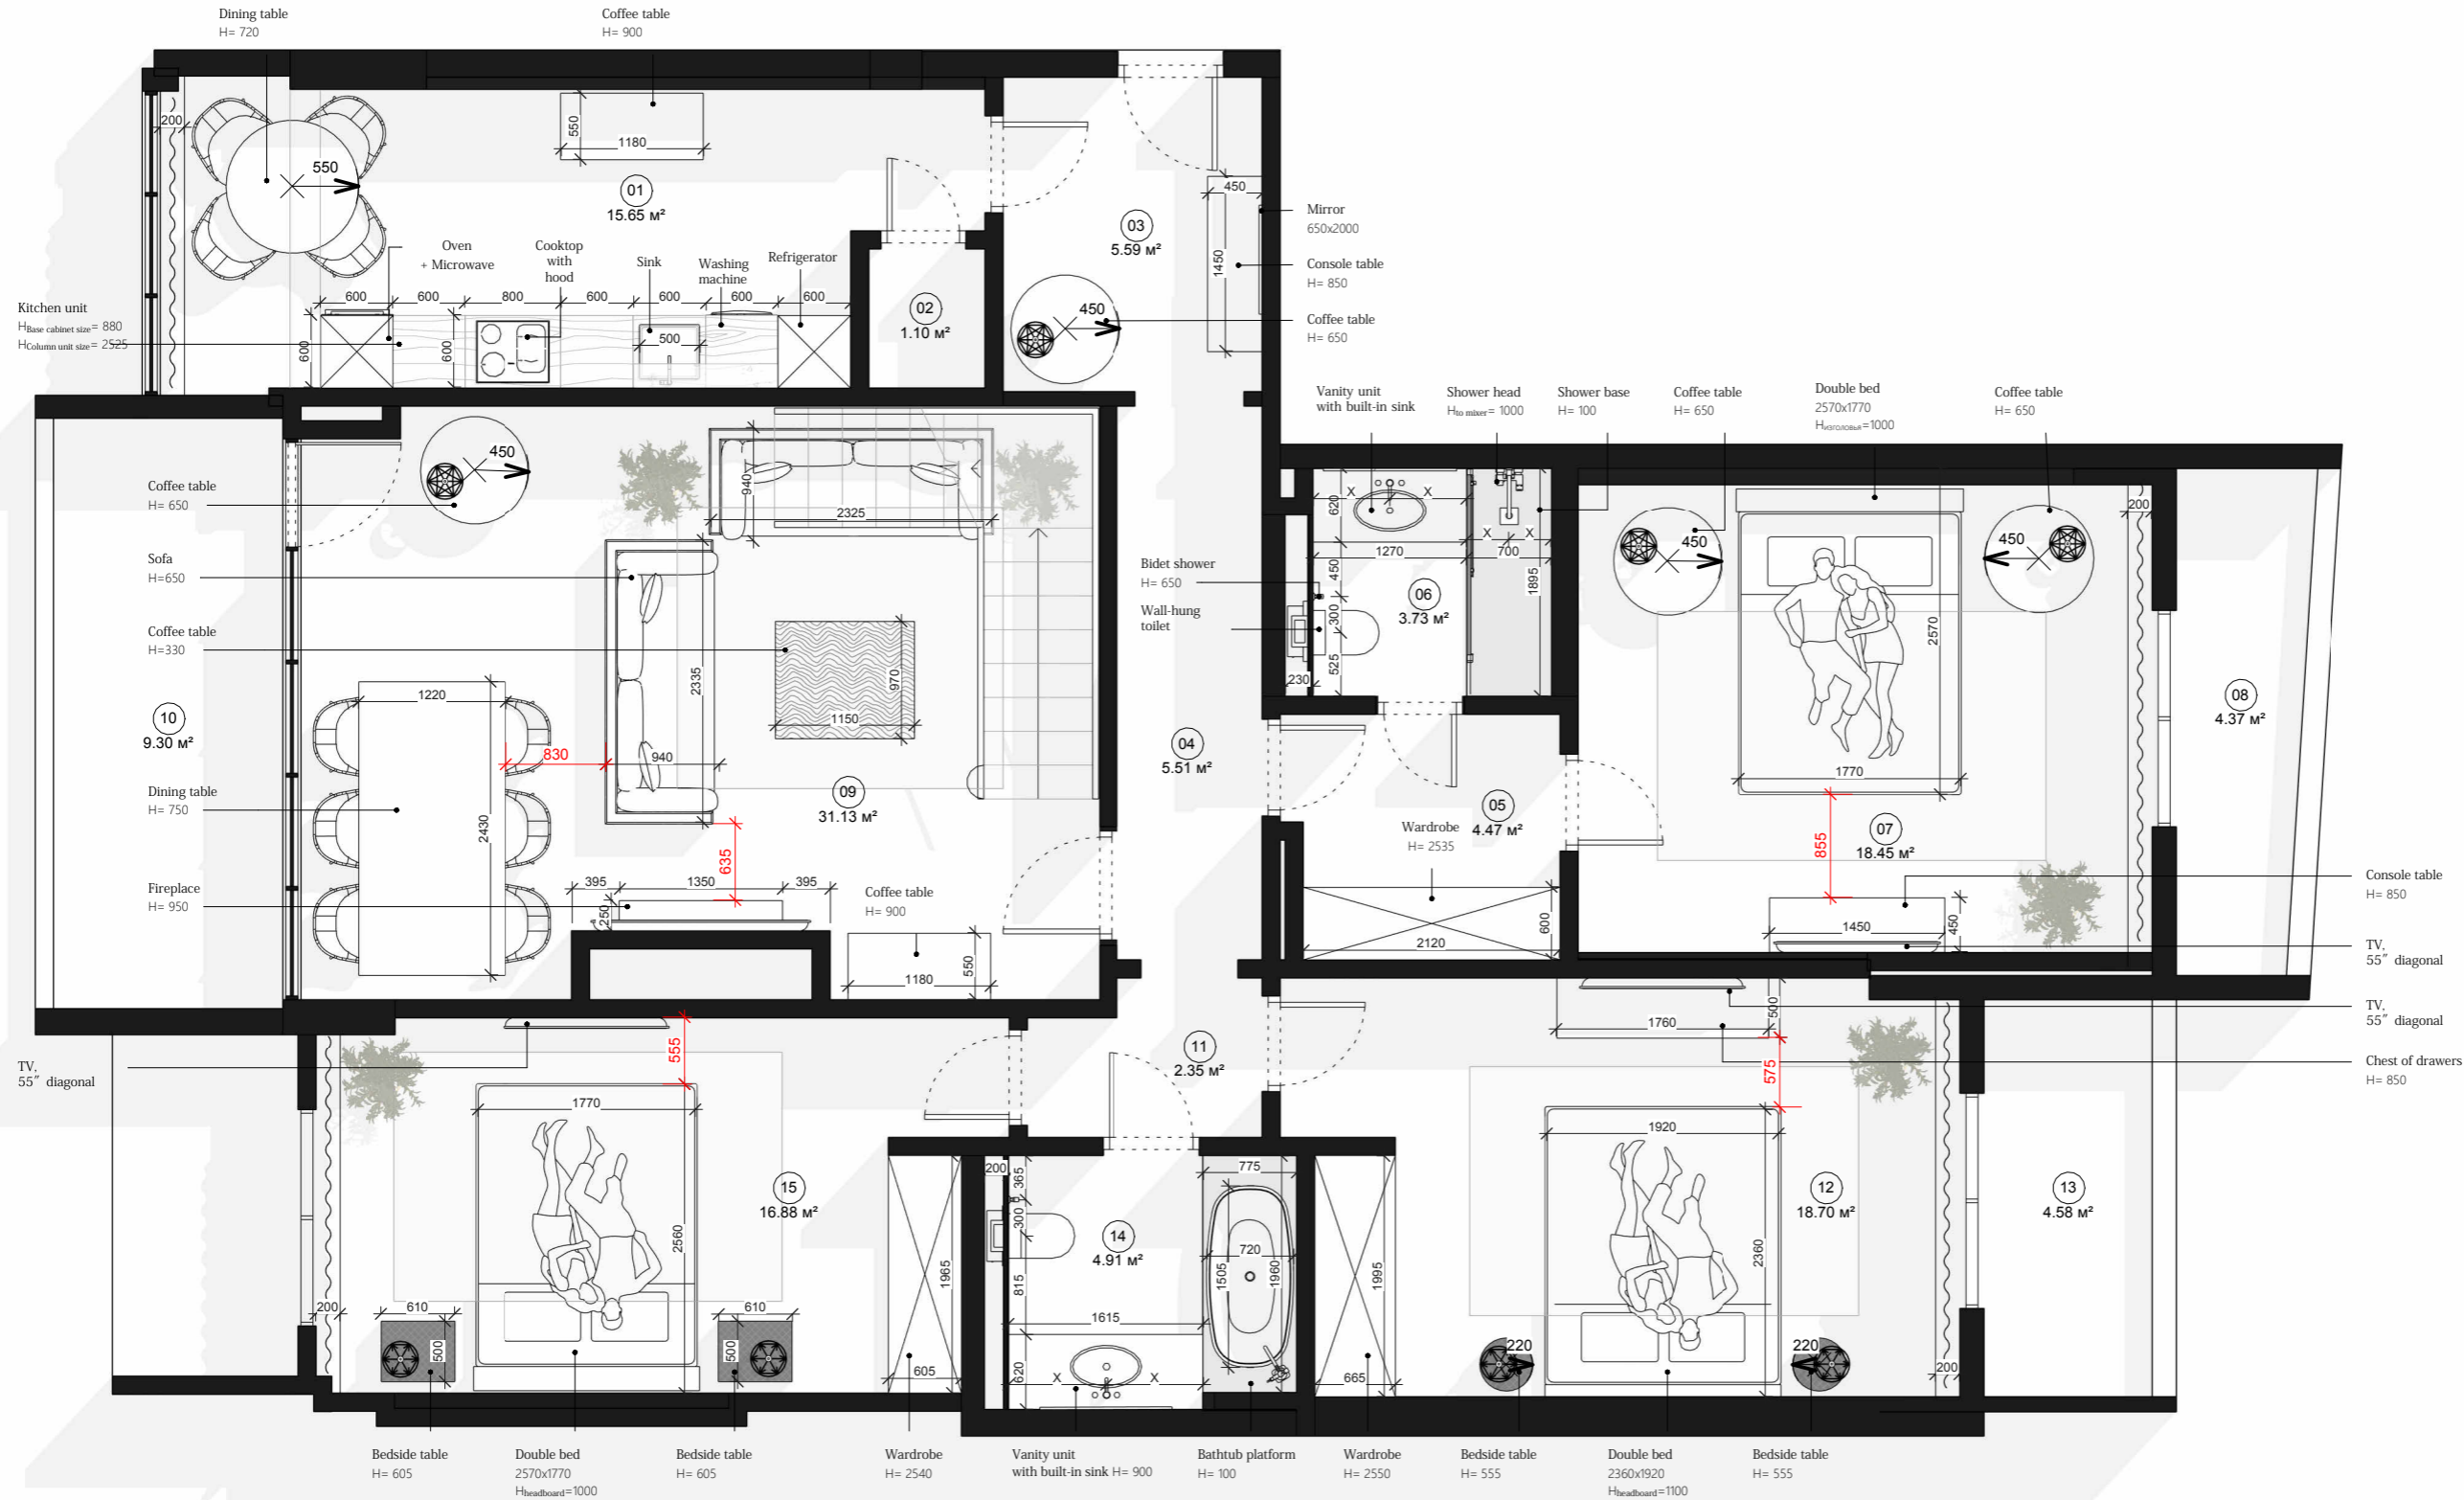



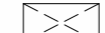
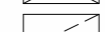
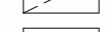
Room schedule, 1st floor (as-built plan)

01	Kitchen	15.65 m ²
02	Storage room	1.10 m ²
03	Entrance hall	5.59 m ²
04	Corridor 1	5.51 m ²
05	Corridor 2	4.47 m ²
06	Bathroom 1	3.73 m ²
07	Master bedroom	18.45 m ²
08	Balcony 1	4.37 m ²
09	Living room	31.13 m ²
10	Balcony 2	9.30 m ²
11	Corridor 3	2.35 m ²
12	Bedroom 1	18.70 m ²
13	Balcony 3	4.58 m ²
14	Bathroom 2	4.91 m ²
15	Bedroom 2	16.88 m ²
In total: 15		146.72 m ²

General Notes

1. Elevation mark 0.000 corresponds to the finished floor level (F.F.L.)
2. Final room dimensions may be adjusted after wall installation and plastering


Legend

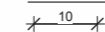-  Main dimensions
-  Critical dimensions (must be observed)
-  Full-height wardrobe (to ceiling)
-  Wall-mounted cabinet
-  Cabinet




Room schedule, 2nd floor (as-built plan)

16	Living room	31.94 m ²
17	Bedroom 3	13.76 m ²
18	Bathroom 3	4.10 m ²
19	Bedroom 4	16.69 m ²
20	Balcony 4	9.84 m ²
In total: 5		76.32 m ²

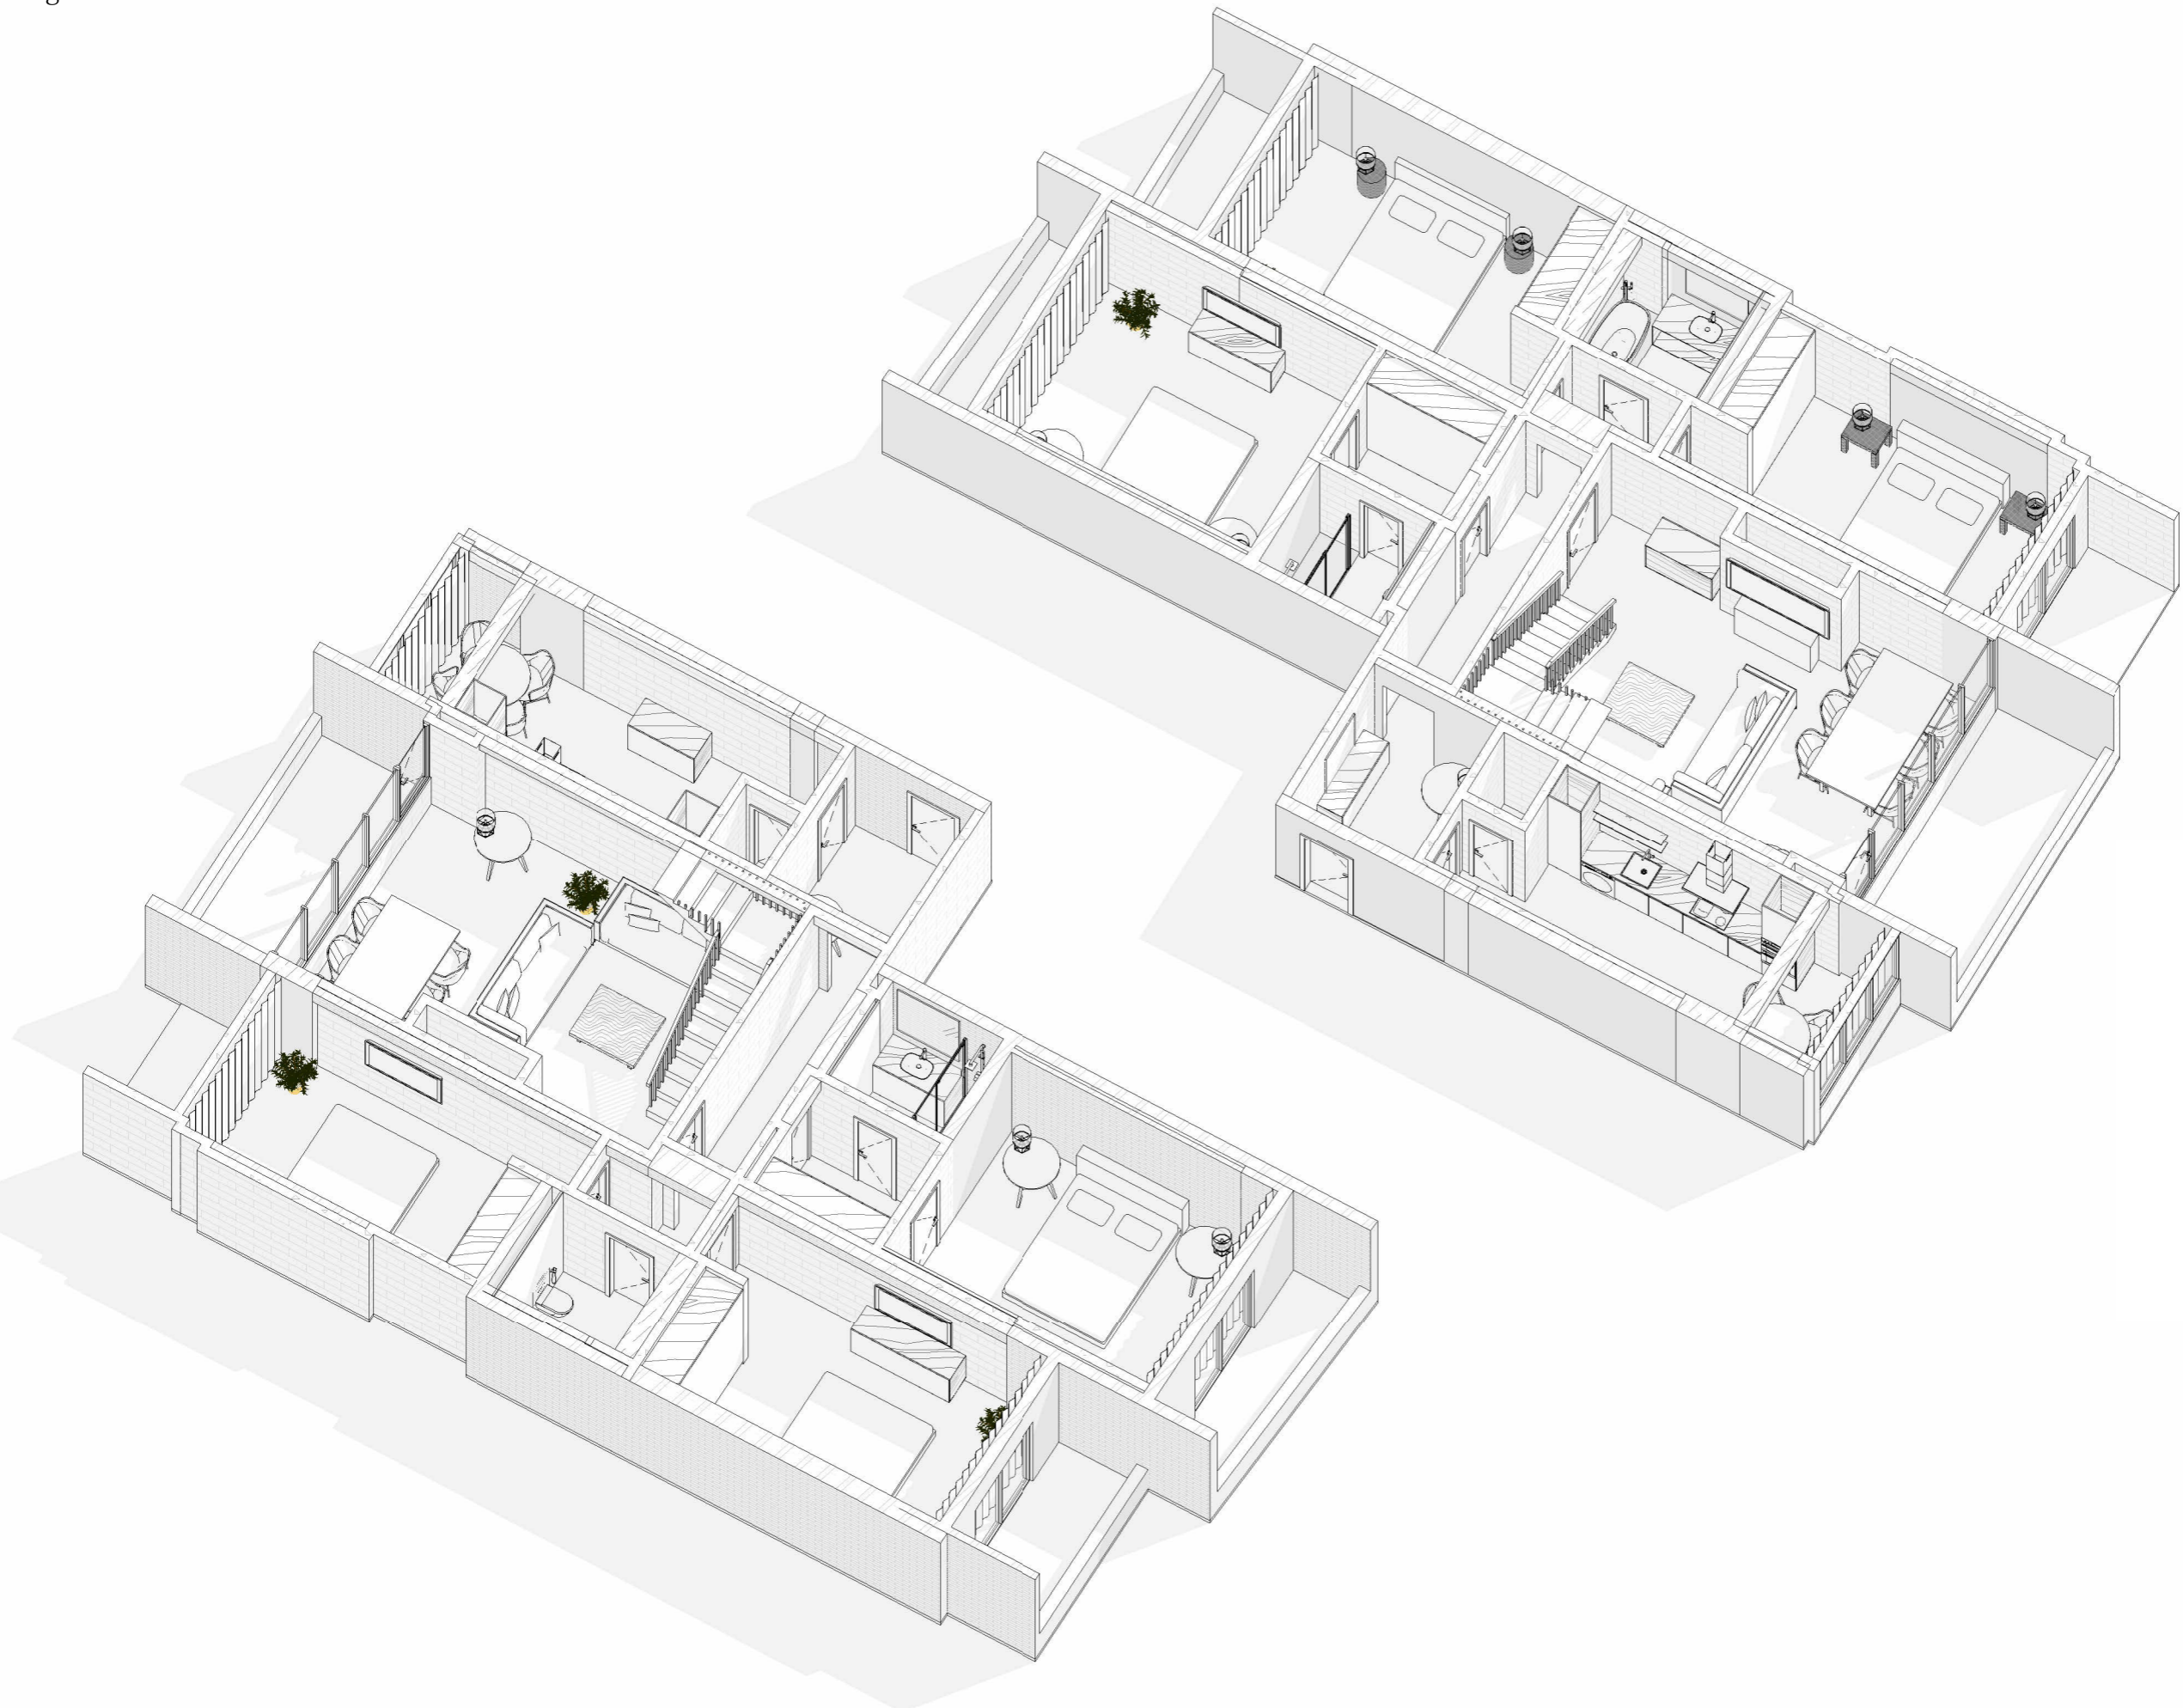

Room schedule, 1st floor (as-built plan)

01	Kitchen	15.65 m ²
02	Storage room	1.10 m ²
03	Entrance hall	5.59 m ²
04	Corridor 1	5.51 m ²
05	Corridor 2	4.47 m ²
06	Bathroom 1	3.73 m ²
07	Master bedroom	18.45 m ²
08	Balcony 1	4.37 m ²
09	Living room	31.13 m ²
10	Balcony 2	9.30 m ²
11	Corridor 3	2.35 m ²
12	Bedroom 1	18.70 m ²
13	Balcony 3	4.58 m ²
14	Bathroom 2	4.91 m ²
15	Bedroom 2	16.88 m ²
In total: 15		146.72 m ²

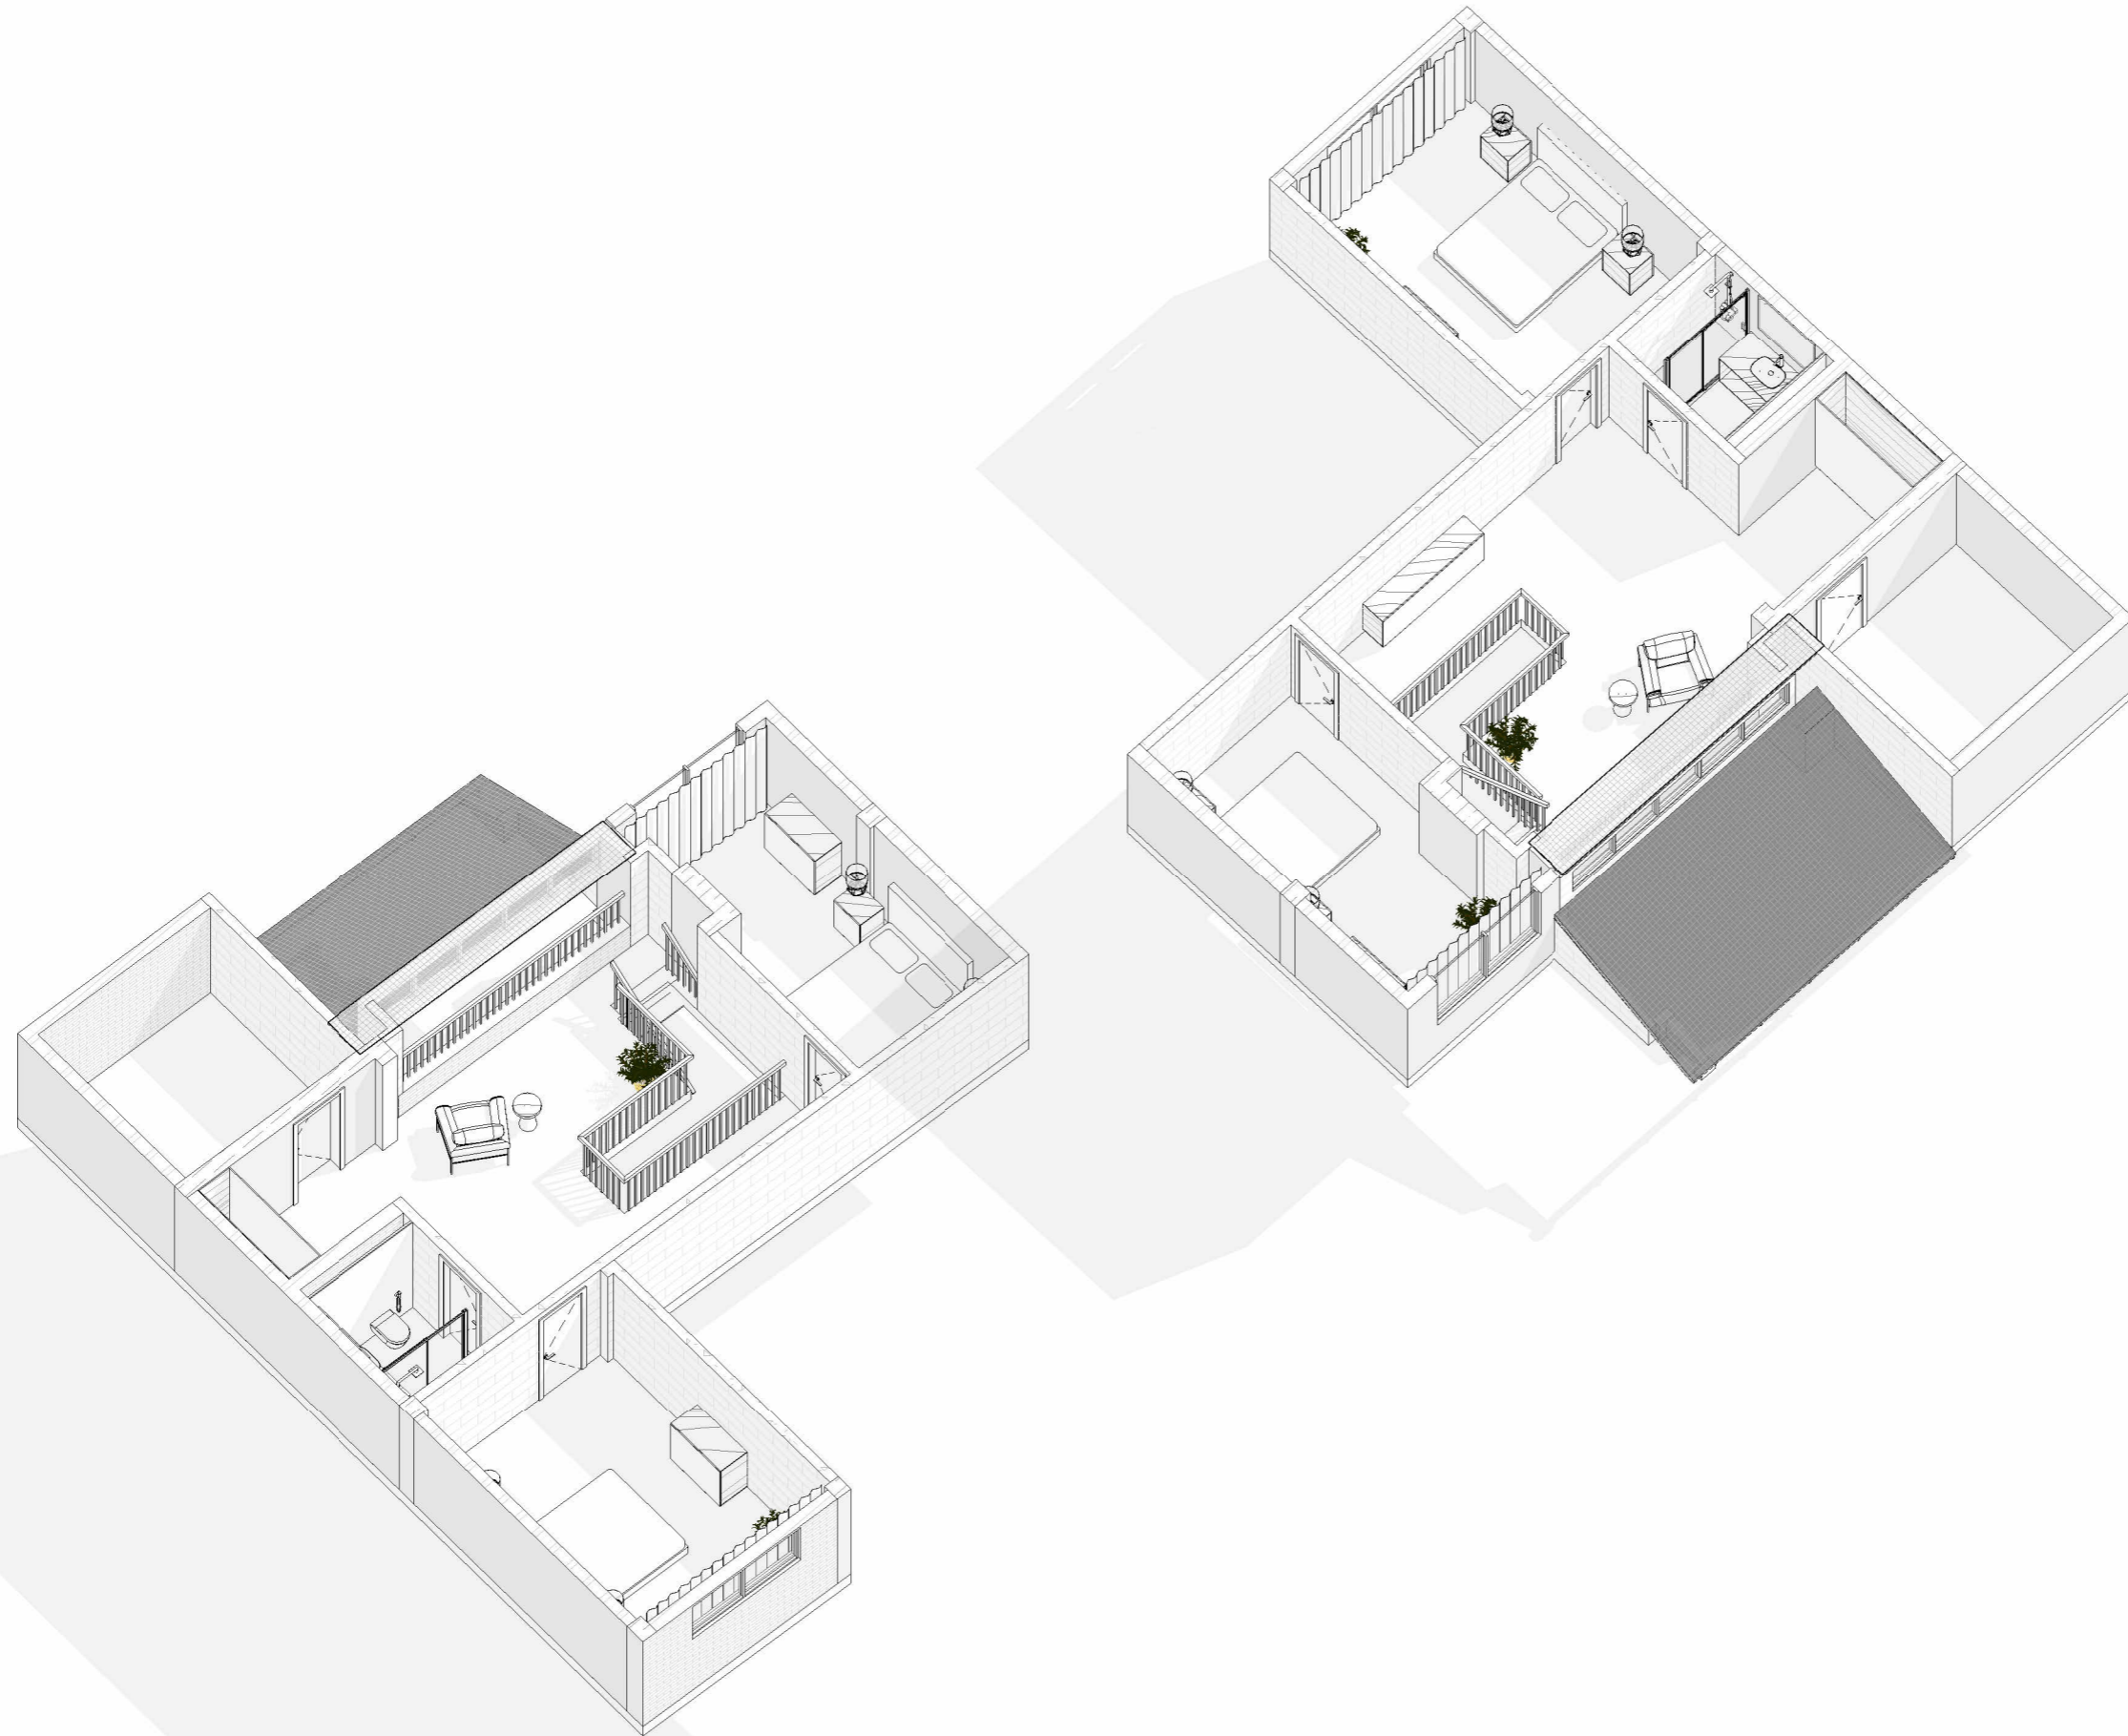

Room schedule, 2nd floor (as-built plan)

16	Living room	31.94 m ²
17	Bedroom 3	13.76 m ²
18	Bathroom 3	4.10 m ²
19	Bedroom 4	16.69 m ²
20	Balcony 4	9.84 m ²
In total: 5		76.32 m ²